
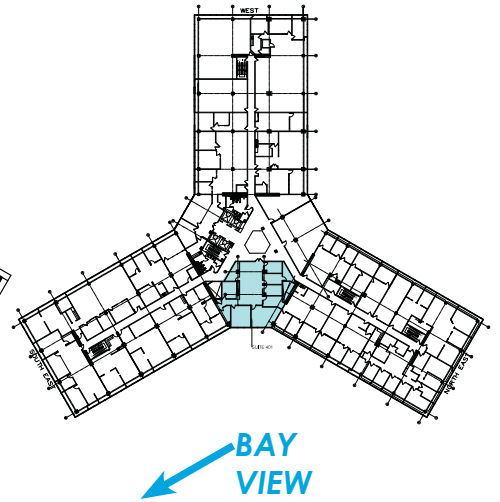


# 400 OYSTER POINT

OYSTER POINT MARINA PLAZA

SUITE 401 | 2,908 RSF

SOUTH SAN FRANCISCO

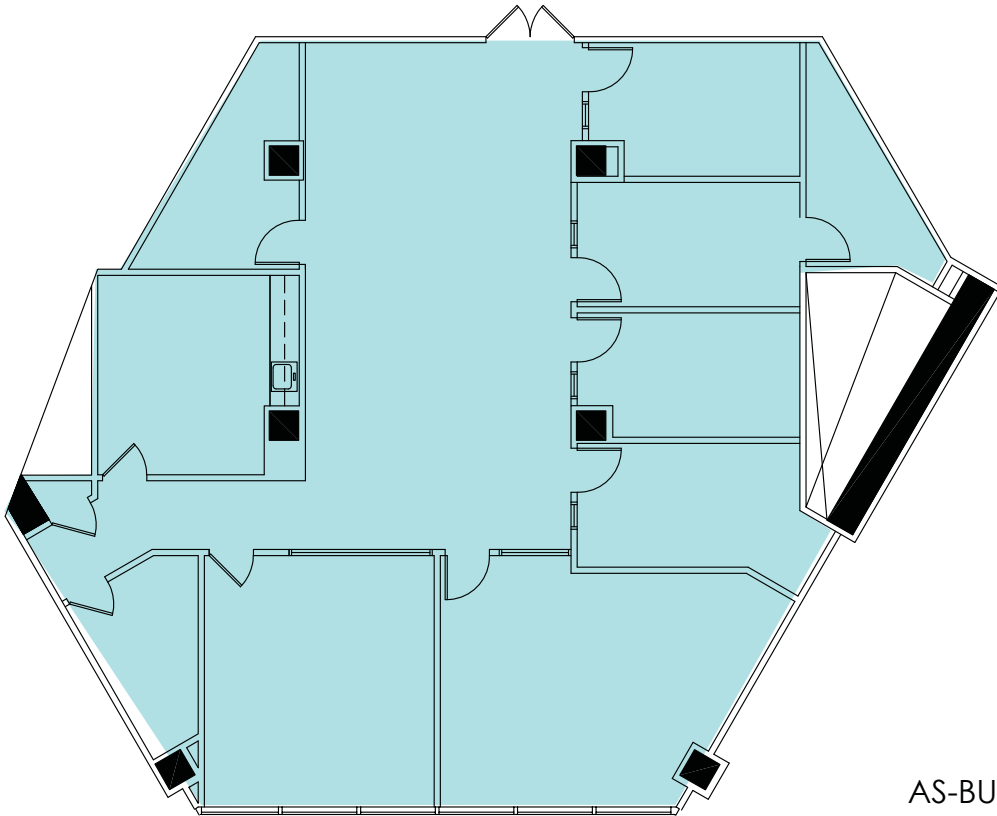

## AS-BUILT CONFIGURATION

OFFICES:	5
CONFERENCE ROOM:	1
BREAK ROOM	1
IT ROOM:	1
STORAGE ROOM:	3
RECEPTION:	1
OPEN AREA:	1



For more information, please contact:

SCOTT ENNIS  
408.572.1545  
scott.ennis@cushwake.com



CLARK STEELE  
408.436.3653  
clark.steele@cushwake.com

