
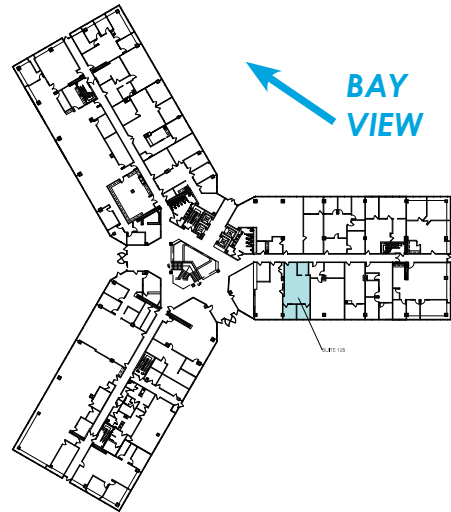


400 OYSTER POINT

OYSTER POINT MARINA PLAZA

SUITE 125 | 852 RSF

SOUTH SAN FRANCISCO

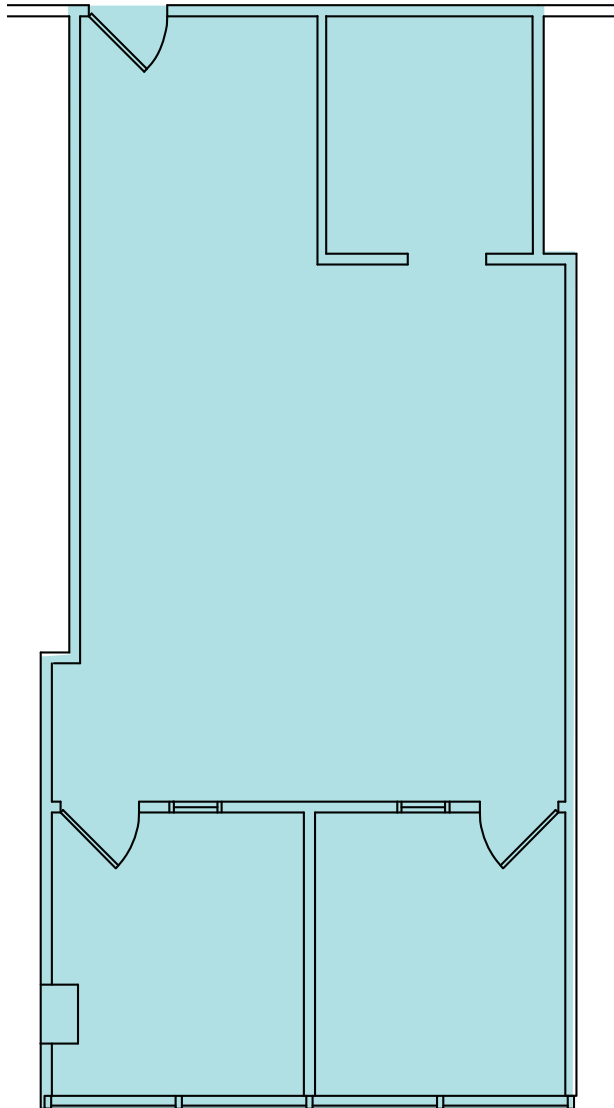

AS-BUILT CONFIGURATION

OFFICES:	2
RECEPTION/LOUNGE	1
IT/STORAGE ROOM:	1



For more information, please contact:

SCOTT ENNIS
408.572.1545
scott.ennis@cushwake.com



CLARK STEELE
408.436.3653
clark.steele@cushwake.com

