
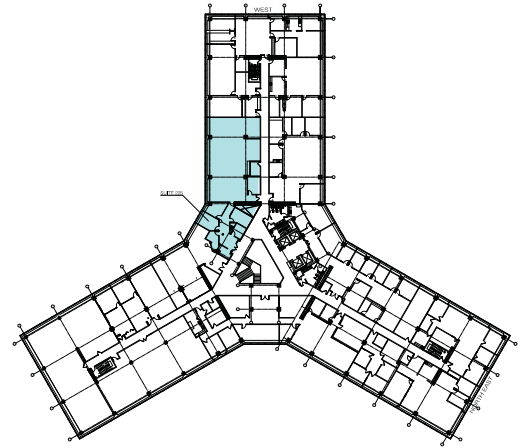


# 395 OYSTER POINT

OYSTER POINT MARINA PLAZA

SUITE 225 | 4,364 RSF

SOUTH SAN FRANCISCO

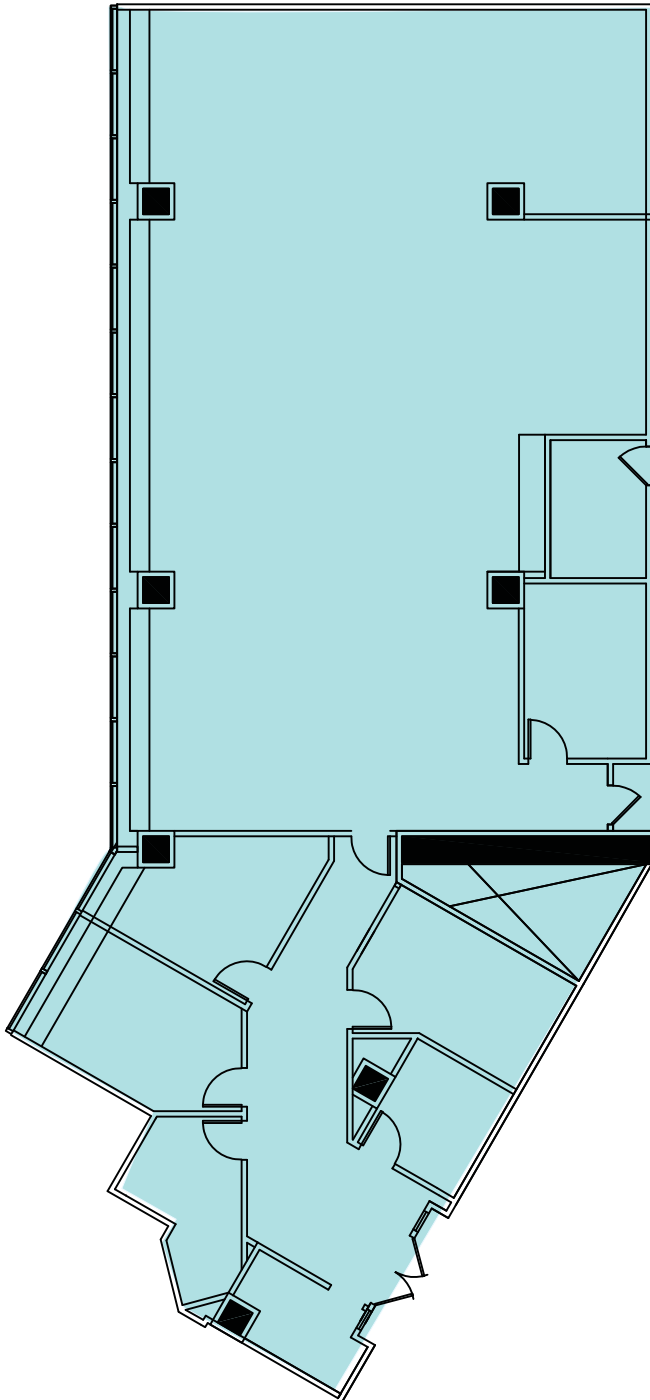

 **BAY  
VIEW**

### AS-BUILT CONFIGURATION

OFFICES:	13
CONFERENCE ROOM:	1
KITCHEN:	2
IT ROOM:	1
STORAGE ROOM:	2



For more information, please contact:

SCOTT ENNIS  
408.572.1545  
scott.ennis@cushwake.com



CLARK STEELE  
408.436.3653  
clark.steele@cushwake.com

