
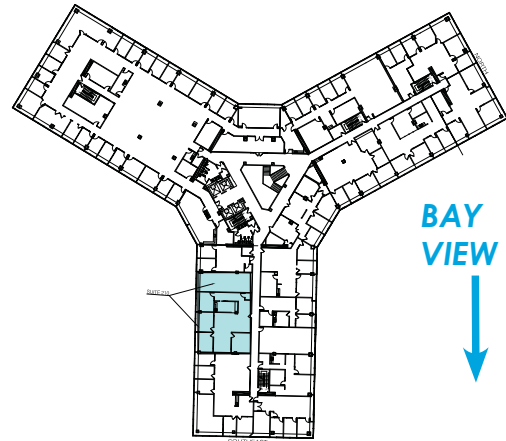


400 OYSTER POINT

OYSTER POINT MARINA PLAZA

SUITE 210 | 2,928 RSF

SOUTH SAN FRANCISCO

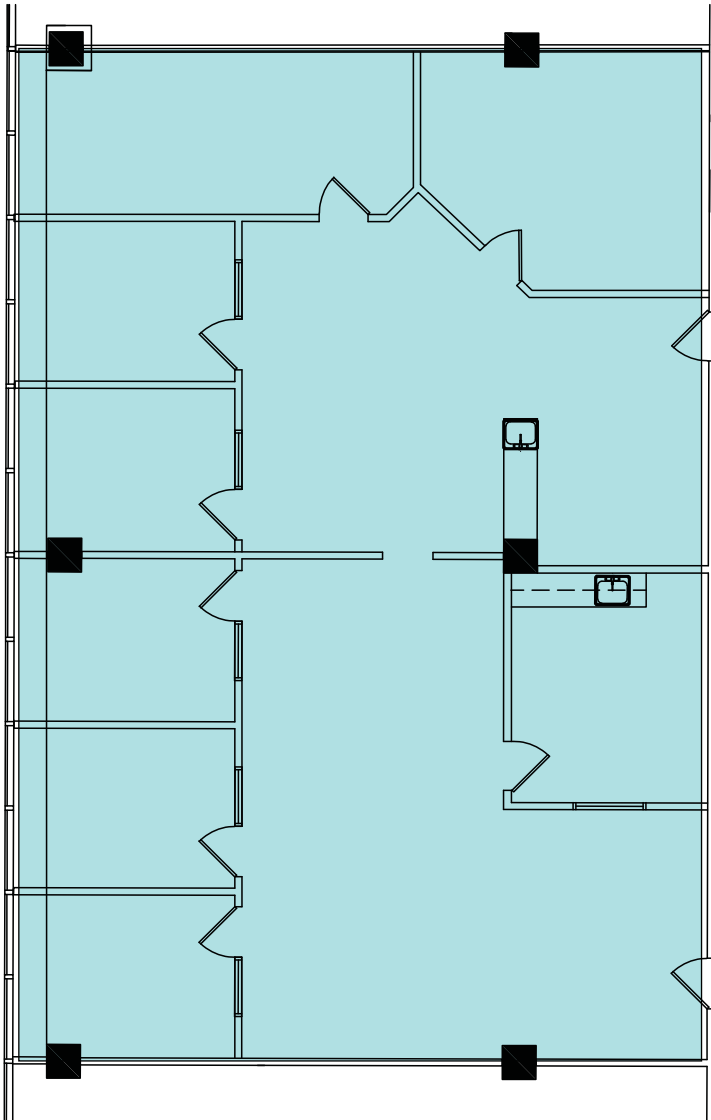

AS-BUILT CONFIGURATION

OFFICES:	6
CONFERENCE ROOM:	1
KITCHEN:	1
STORAGE ROOM:	2
OPEN AREA:	2



For more information, please contact:

SCOTT ENNIS
408.572.1545
scott.ennis@cushwake.com



CLARK STEELE
408.436.3653
clark.steele@cushwake.com

