
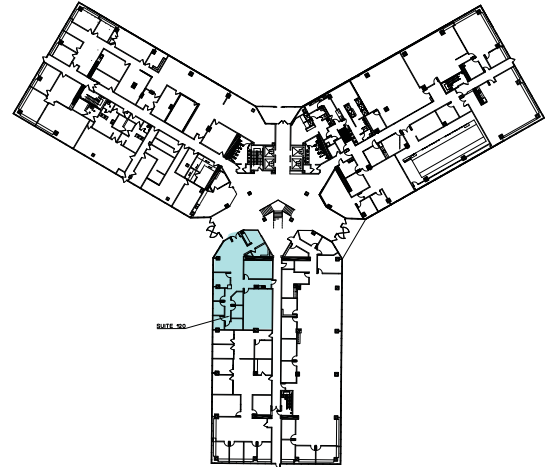


395 OYSTER POINT

OYSTER POINT MARINA PLAZA

SUITE 120 | 2,775 RSF

SOUTH SAN FRANCISCO

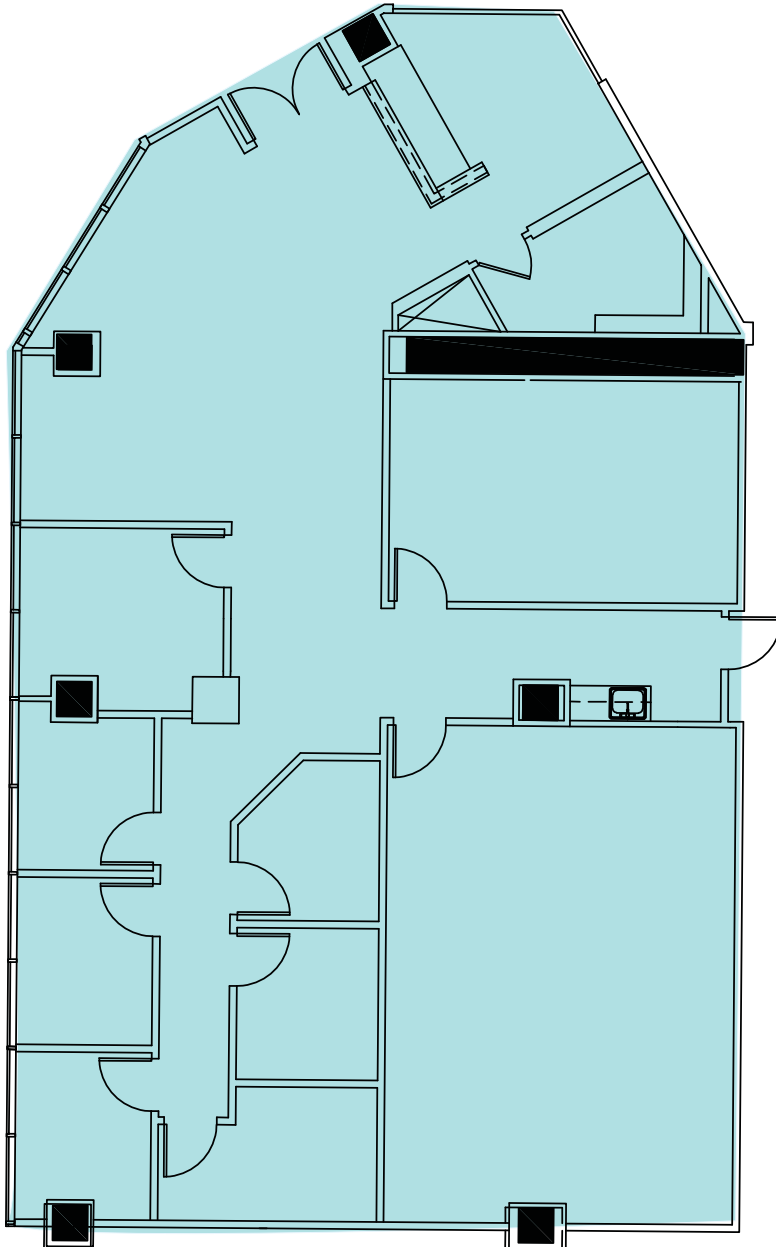

← BAY VIEW

AS-BUILT CONFIGURATION

OFFICES:	7
CONFERENCE ROOM:	2
STORAGE ROOM:	1
RECEPTION:	1



For more information, please contact:

SCOTT ENNIS
408.572.1545
scott.ennis@cushwake.com



CLARK STEELE
408.436.3653
clark.steele@cushwake.com

